





11 = 40, H0212
11 = 41, VENT

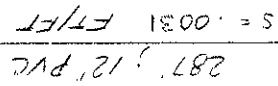

1" = 40' HORIZ
1" = 4' VERT

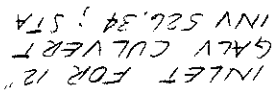

STA 10+76.2
MATCH LINE

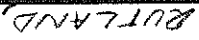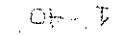

WASTE WATER

Precision Park
No. Springfield,
Vermont 05150