

BEGINNING AT THE INTERSECTION OF DORR DR (TH 10) AND RIVER ST (TH 8)
AND EXTENDING EASTERLY ALONG RIVER ST (TH 8), 0.17 MILES.

BEGINNING ON DORR DR (TH 10) AT A POINT 0.058 MILES SOUTH OF THE
INTERSECTION OF RIVER ST (TH 8) AND DORR DR (TH 10) AND EXTENDING
NORTHERLY ALONG
DORR DR 0.16 MILES

LENGTH OF ROADWAY (TH-10) = 850.0 FEET = 0.16 MILES

LENGTH OF ROADWAY (TH-8) = 700.0 FEET = 0.13 MILES

LENGTH OF BRIDGE = ?

LENGTH OF PROJECT = ?

STATE OF VERMONT AGENCY OF TRANSPORTATION



PROPOSED IMPROVEMENT


BRIDGE PROJECT

CITY OF RUTLAND

COUNTY OF RUTLAND

TH-8 (RIVER STREET) URBAN COLLECTOR

TH-10 (DORR DRIVE) URBAN COLLECTOR

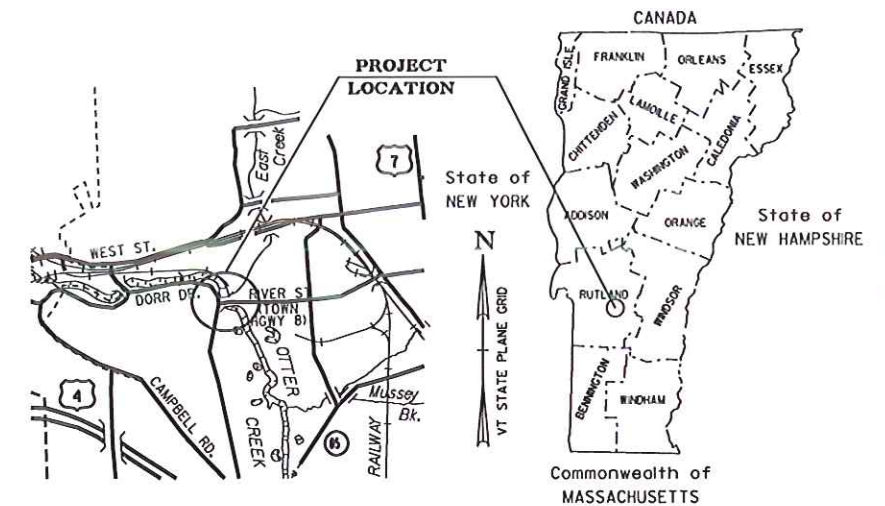

Field Review
Nov. 7, 2011

EXISTING UTILITIES

- CUPS - Electric (distribution, 3-phase and transmission)
- fairpoint
- City of Rutland (water, sewer (sanitary) and storm sewer)
- Comcast (verify ownership)
- Verify if there are any third party fiber optics (e.g. sovereign, level 3, charter, etc...)
- Not evident - check ^{but} if fire alarm cable is present.

City of Rutland provided plans, the sheets and profiles of their facilities - that info is separate and not shown on these mark-ups for clarity.

THESE PLANS ARE SUBJECT TO SUCH ENGINEERING CHANGES AS MAY BE REQUIRED BY THE FEDERAL HIGHWAY ADMINISTRATION OR THE DIRECTOR OF PROGRAM DEVELOPMENT.
CONSTRUCTION IS TO BE CARRIED ON IN ACCORDANCE WITH THESE PLANS AND THE STANDARD SPECIFICATIONS FOR CONSTRUCTION DATED 2011, AS APPROVED BY THE FEDERAL HIGHWAY ADMINISTRATION ON JULY 20, 2011 FOR USE ON THIS PROJECT, INCLUDING ALL SUBSEQUENT REVISIONS AND SUCH REVISED SPECIFICATIONS AND SPECIAL PROVISIONS AS ARE INCORPORATED IN THESE PLANS.

DIRECTOR OF PROGRAM DEVELOPMENT
APPROVED _____ DATE _____

PROJECT MANAGER : C. CARLSON

PROJECT NAME : RUTLAND CITY
PROJECT NUMBER : BRP 3000 (16)

SHEET 1 OF SHEETS

QUALITY ASSURANCE PROGRAM: LEVEL

CONVENTIONAL SYMBOLS

COUNTY LINE	
TOWN LINE	
LIMITS OF ACCESS	
POINT OF ACCESS	
FENCE LINE	
STONE WALL	
TRAVELED WAY	
GUARD RAIL	
RAILROAD	
SURVEY LINE	
CULVERT	
POWER POLE	
TELEPHONE POLE	
TREES	
CONTROL OF ACCESS	
PROPERTY LINE	
R.O.W. TAKING LINE	
SLOPE RIGHTS	
TOP OF CUT	
TOE OF SLOPE	


SURVEYED BY :
SURVEYED DATE :

DATUM
VERTICAL
HORIZONTAL




SCALE 1" = 100' - 0"
100 0 100

* SEE PLANS, PROFILES, AND TIE SHEETS PROVIDED BY THE CITY OF PORTLAND FOR THEIR UTILITY INFRASTRUCTURE (e.g., water, San. sewer, and storm sewer)

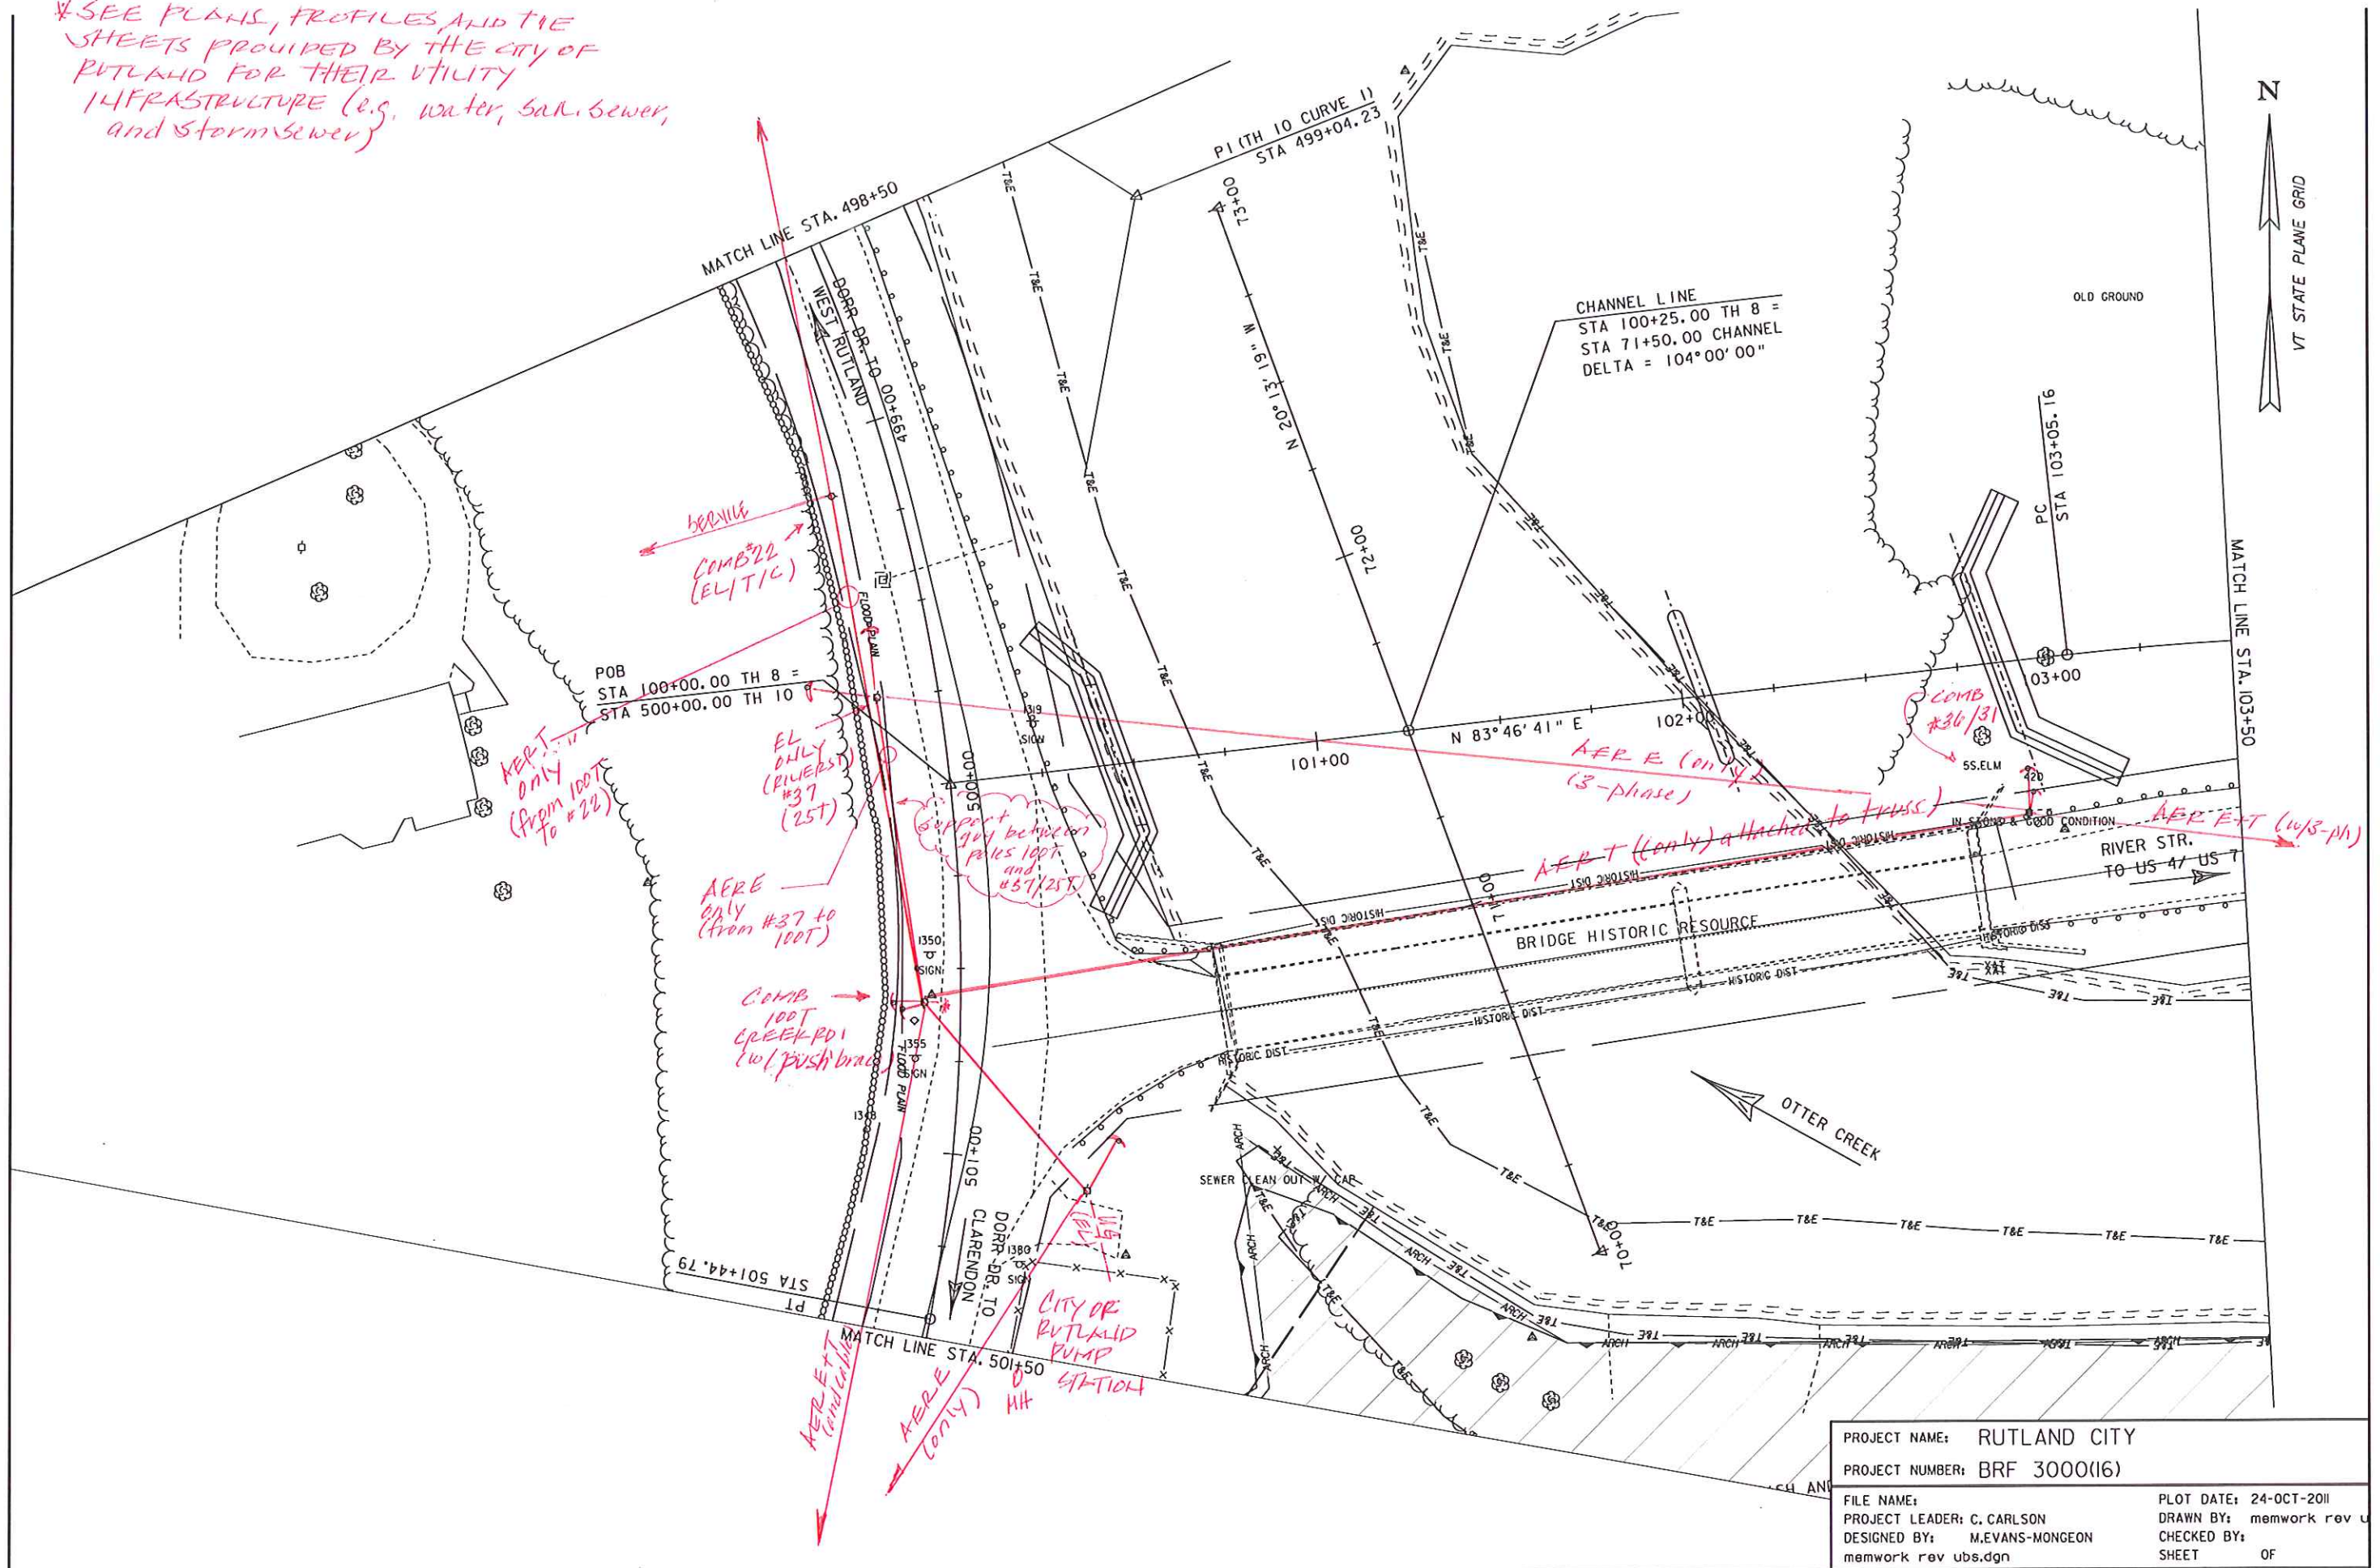



Field: 11/7/11

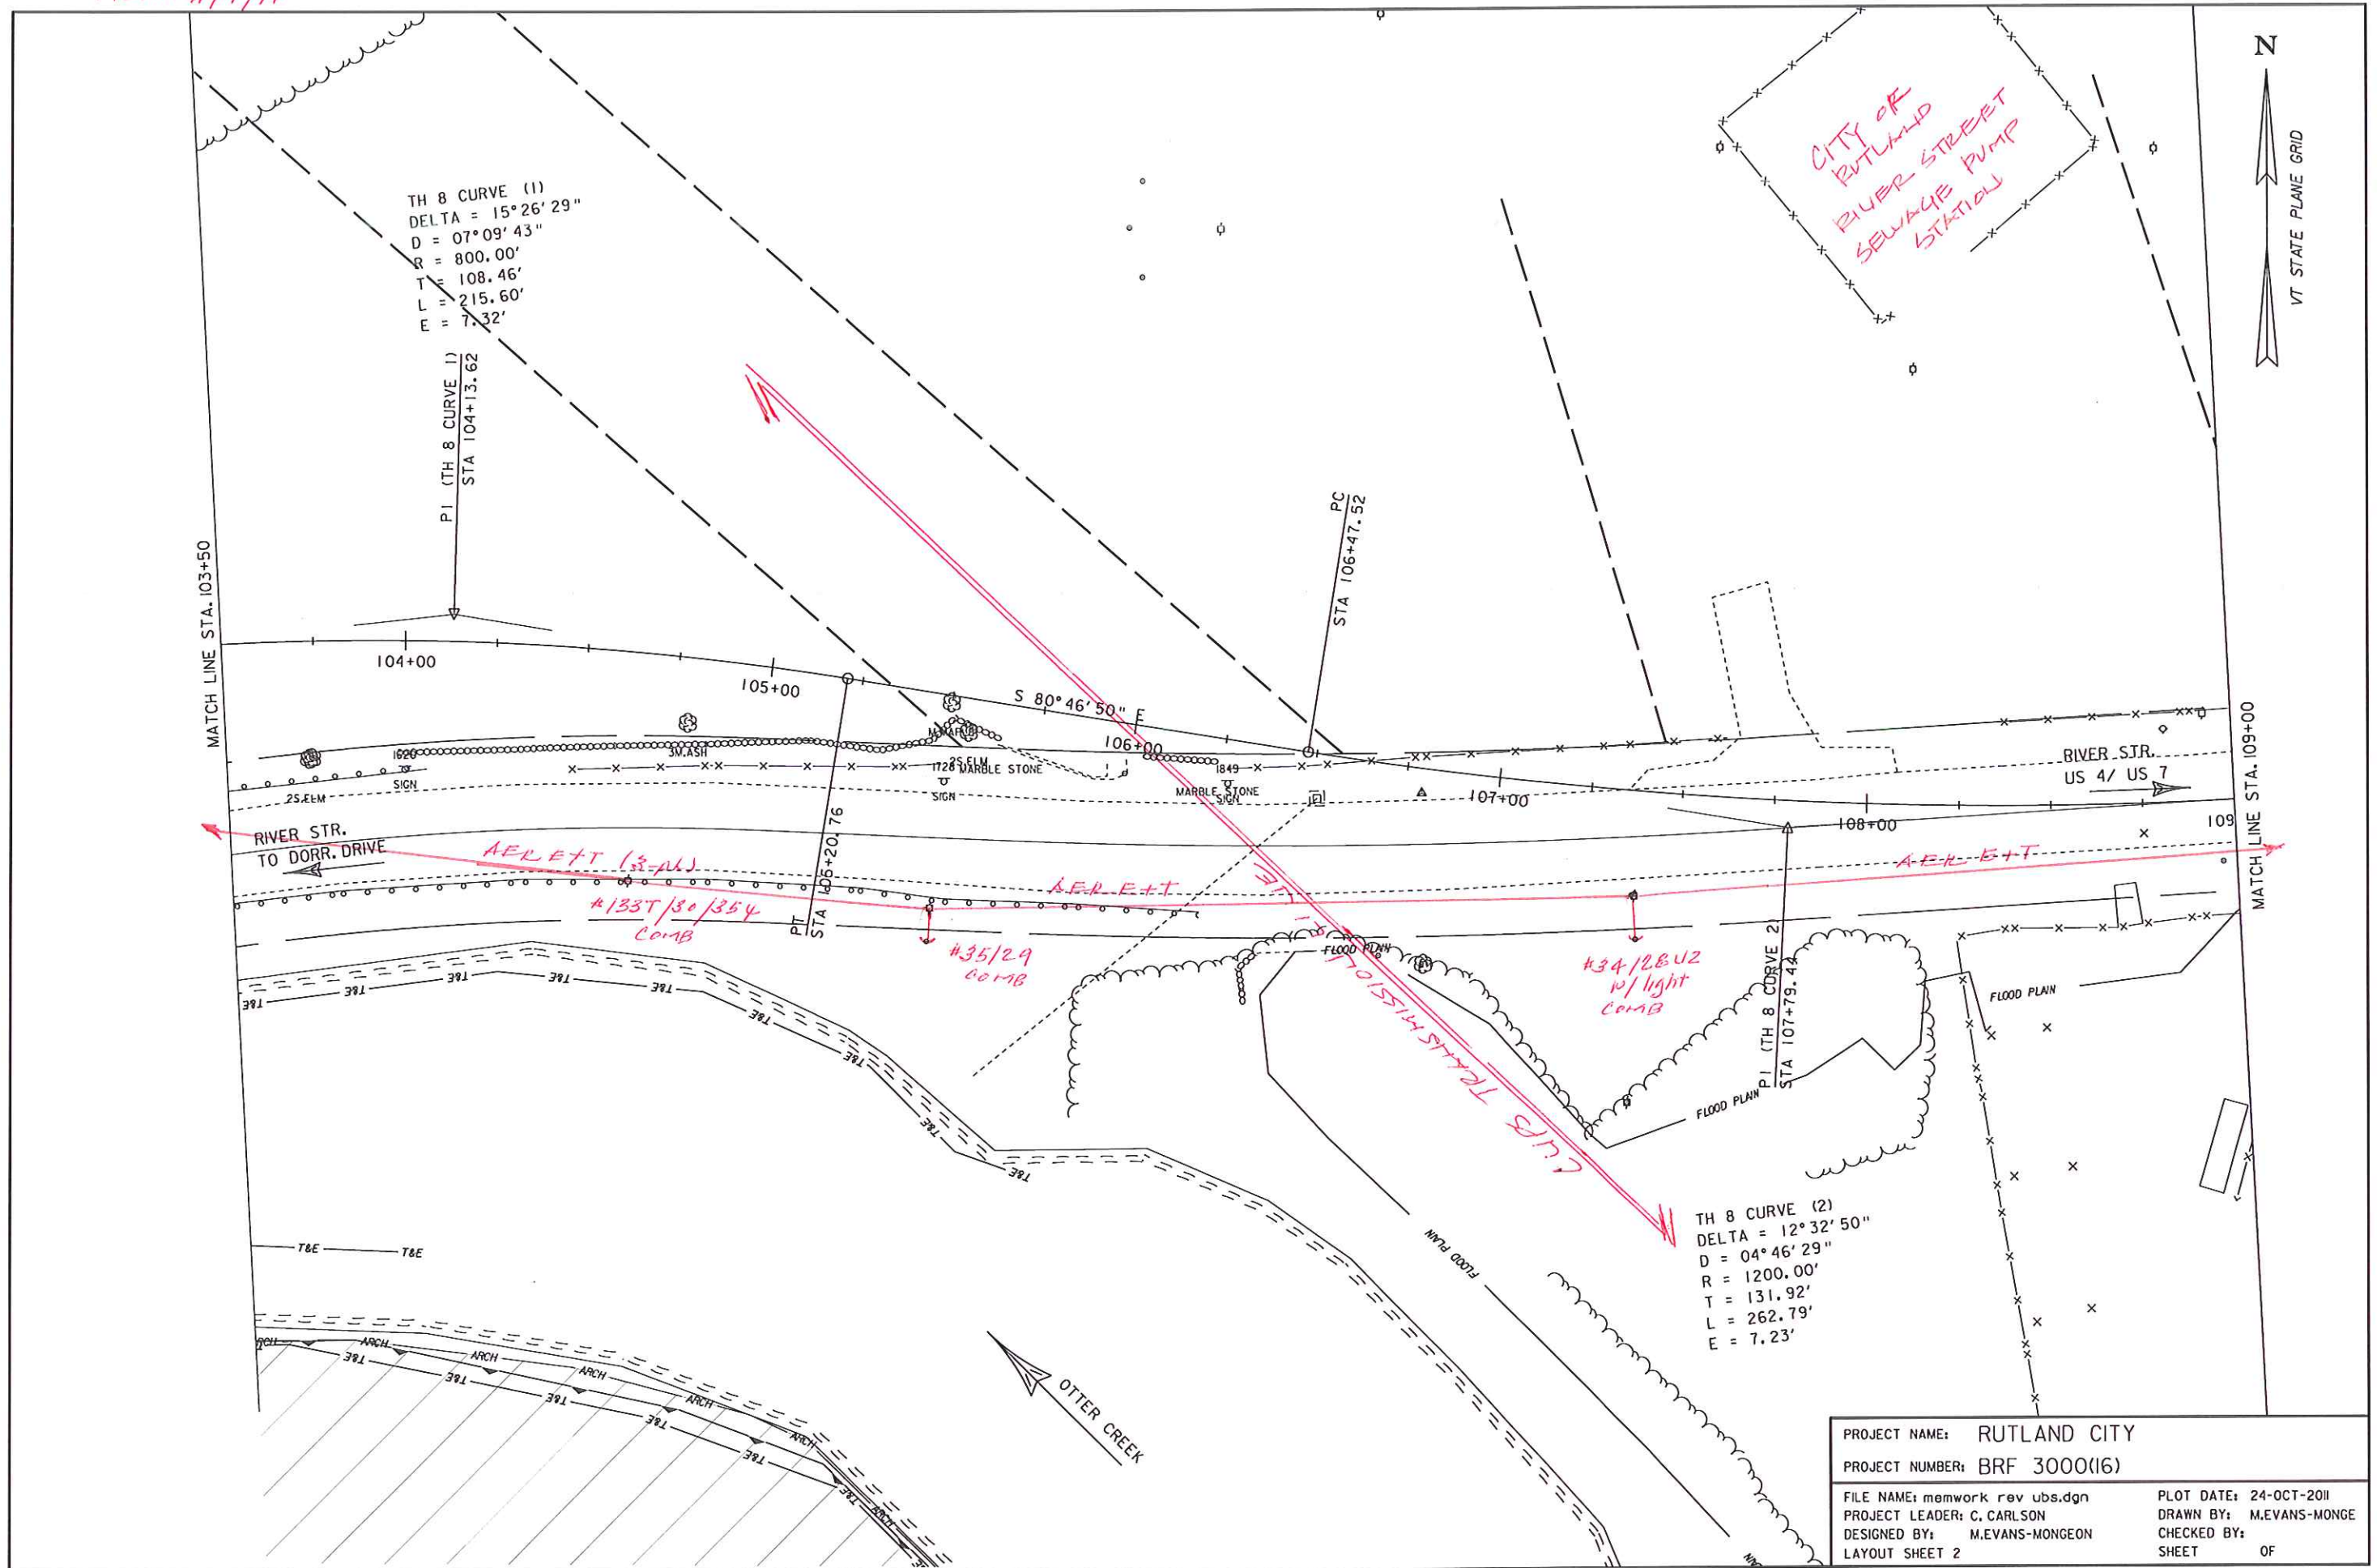

Field: 11/7/11

COURCELLE SURVEY R.L.S.#533

A.O. L.S.529

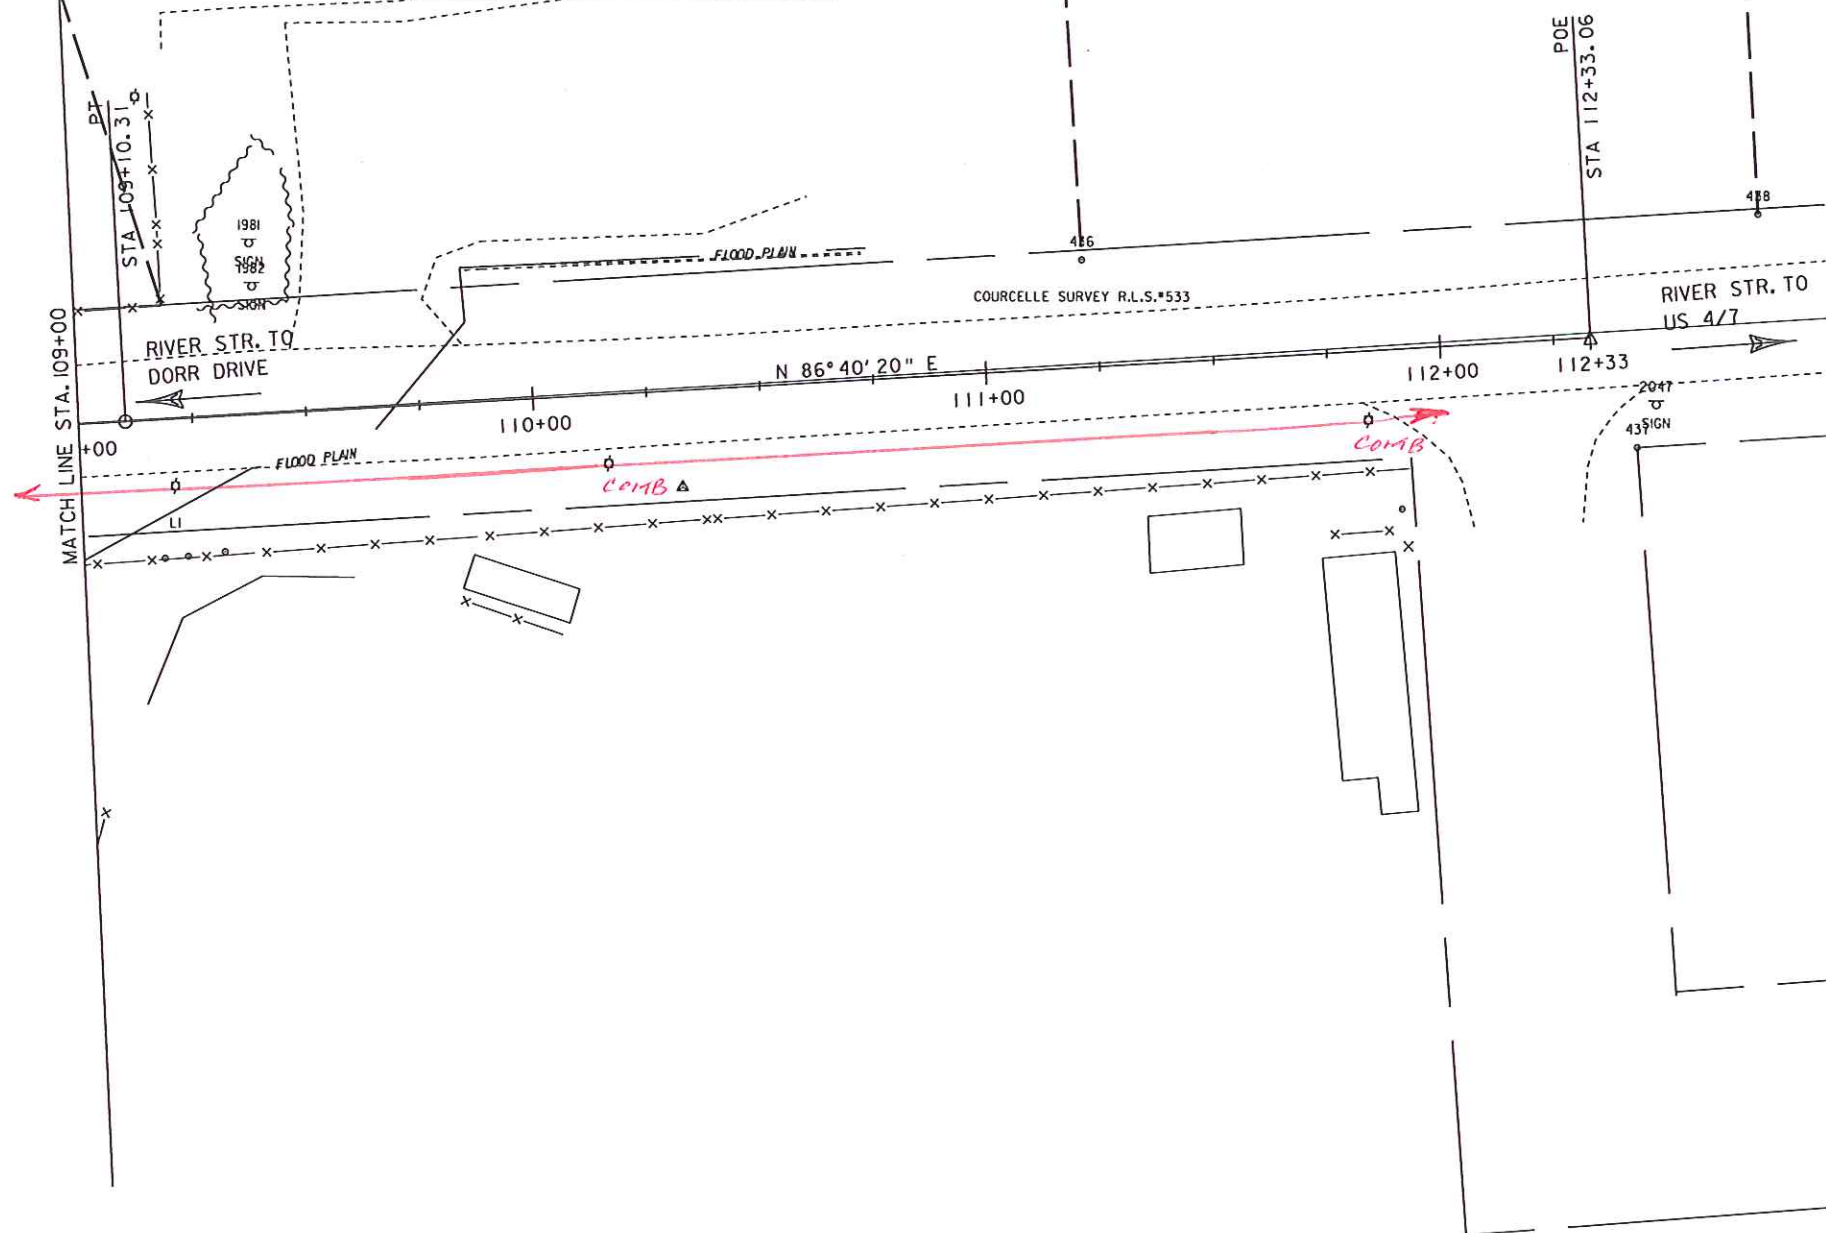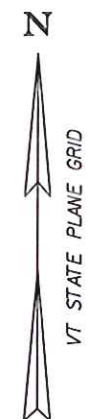


PROJECT NAME: RUTLAND CITY

PROJECT NUMBER: BRF 3000(16)

FILE NAME: memwork rev obs.dgn
PROJECT LEADER: C. CARLSON
DESIGNED BY: M.EVANS-MONGEON
LAYOUT SHEET 3

PLOT DATE: 24-OCT-2011
DRAWN BY: EVANS-MONGEON
CHECKED BY:
SHEET OF

Field: 11/7/11

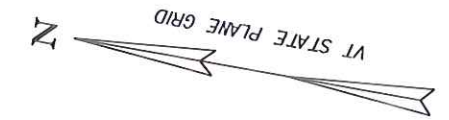

Area tested by UVM and cleared for Ar

CLASS II WETLANDS

AREA (only)

DORR DR. TO
RIVER STR.

FLOOD PLAN

AREA (cable)

AREA (cable)

DORR DR. TO
CLARENDON

AREA (cable)

AREA (cable)

underground service (approx.)

PROJECT NAME: RUTLAND CITY

PROJECT NUMBER: BRF 3000(16)

FILE NAME: memwork rev ubs.dgn

PROJECT LEADER: C. CARLSON

DESIGNED BY: M. EVANS-MONGEON

PLOT DATE: 24-OCT-2011

DRAWN BY: EVANS-MONGEON

CHECKED BY:

SHEET OF

OTTER CREEK

VT STATE PLANE GRID

ARCH

FLOOD PLAIN

POB STA 495+55.80

DORR DR. TO WEST RUTLAND

DORR DR. TO RIVER STREET

MATCH LINE STA. 498+50

PC 495+36.95

PCC 497+59.54

STA 496+00

STA 497+59.54

STA 498+00

STA 499+00

STA 500+00

STA 762+00

STA 763+

PLOT DATE: 24-OCT-2011
DRAWN BY: EVANS-MONGEON
CHECKED BY:
SHEET OF